


BLDG. NO.	DESCRIPTION	TYPE & CAPACITY	KEY PLAN NO.	JOB NO.	SHEET
T162	Crew Shelter	2-Crews	T03-25-9	A-1	2
T163	A.C. Fueling System	Pump & Engine 2,500 gal. tanks	T25-13-11	A-1	2
T164	Crew Shelter	2-Crews	T03-25-9	A-1	2
T165	Crew Shelter	2-Crews	T03-25-9	A-1	2
T166	A.C. Fueling System	Pump & Engine 2,500 gal. tanks	T25-13-11	A-1	2
T167	Crew Shelter	2-Crews	T03-25-9	A-1	2
T168	Crew Shelter	2-Crews	T03-25-9	A-1	2
T169	Crew Shelter	2-Crews	T03-25-9	A-1	2
T170	A.C. Fueling System	Pump & Engine 2,500 gal. tanks	T25-13-11	A-1	2
T171	Crew Shelter	2-Crews	T03-25-9	A-1	2
T200	Pump House Well No. 3	Pump, Meter, Stand, Tank & Connections	150-25-512	A-1	2-3
T223	Bomb Slight Storage	Cell Type 192 sq. ft.	150-25-496	A-1	1-2-3
T224	Operations Bldg.	1,200 sq. ft.	T03-25-7	A-1	1-2-3
T227	Link Trainer Bldg.	A.A. Mod. Link Trainer	150-25-404	A-1	1-2-3
T240	Control Tower	Wood 225 sq. ft.	150-25-392	A-1	1-2-3
T241	Shop	2000 sq. ft.	T03-25-7	A-1	1-2-3
T-242	School	8 Tables, 16 Benches	T03-25-35	SPDA-30	1-2-3
T260	Crash Truck Station	FSCT, 2 Trucks	T0 700-6616	PD-A-142	1-2-3
T261	Latrine	Pit, 8 Holes	T0-11-30	A-1	1-2-3
T265	Maintenance Nose Hanger	8926 sq. ft.	150-25-609	A-3-1	1-2-3
T270	Beacon	Rotating	150-25-102	T0A-305	1-2-3
T300	Wind Tee	Illuminated	150-25-466	A-1	1-2-3

BLDG. NO.	DESCRIPTION	TYPE & CAPACITY	KEY PLAN NO.	JOB NO.	SHEET
T1	E.M. Barracks with bunks	52 Man	T05-25-7	A-1	1-3
T2	E.M. Barracks with bunks	52 Man	T05-25-7	A-1	1-3
T3	E.M. Barracks with bunks	52 Man	T05-25-7	A-1	1-3
T4	E.M. Barracks without bunks	2000 Sq. Ft.	T05-25-7	A-1	1-3
T5	Dispensary	3100 Sq. Ft.	T05-1155	A2-1	1-3
T6	Latrine	Pit, 8 Holes	T0-11-30	A-1	1-3
T7	Bath House	Pit, 150 Man	T05-25-9	A-1	1-3
T8	Latrine	Pit, 8 Holes	T0-11-30	A-1	1-3
T9	Bath House	Pit, 150 Man	T05-25-9	A-1	1-3
T10	E.M. Barracks with bunks	52 Man	T05-25-7	A-1	1-3
T11	E.M. Barracks with bunks	52 Man	T05-25-7	A-1	1-3
T12	E.M. Barracks with bunks	52 Man	T05-25-7	A-1	1-3
T13	E.M. Barracks with bunks	52 Man	T05-25-7	A-1	1-3
T14	E.M. Barracks with bunks	52 Man	T05-25-7	A-1	1-3
T15	E.M. Barracks without bunks	2000 Sq. Ft.	T05-25-7	A-1	1-3
T20	Mass Hall	400 Man	T05-25-10	A-1	1-3
T23	Gasoline Pump and Tank	700 gal.	Post Engineer		1-3
T25	Motor Repair Shop	894 Sq. Ft.	Post Engineer		1-3
T26	Dispatchers Bldg.	137 Sq. Ft.	Post Engineer		1-3
T27	Grease Pit	1 Vehicle	Post Engineer		1-3
T30	Officers Quarters	12 Room	T05-25-7	A-1	1-3
T50	Pump House Well No. 1	Pump, Meter and Connections	150-25-512	A-1	1-3
T54	Water Tower	25,000 gal. Tank	150-25-419	A-1	1-3
T56	Pump House Well No. 2	Pump, Meter and Connections	150-25-512	A-1	1-3
T60	Flag Pole				1-8
T64	Bath House	Pit, 8 Holes	T05-25-9	A-1	1-3
T67	Latrine	Pit, 8 Holes	T0-11-30	A-1	1-3
T69	Officers Quarters	12 Room	T05-25-7	A-1	1-3
T70	Officers Quarters	12 Room	T05-25-7	A-1	1-3
T74	Officers Quarters	12 Room	T05-25-7	A-1	1-3
T85	Agitation Bldg.	2000 Sq. Ft.	T05-25-7	A-1	1-3
T95	Radio Direction Finder Bldg.				1
T100	Bomb Storage	896 Sq. Ft.	150-25-247	A-1	1-2
T101	Bomb Storage	896 Sq. Ft.	150-25-247	A-1	1-2
T102	Bomb Storage	896 Sq. Ft.	150-25-247	A-1	1-2
T103	Bomb Storage	896 Sq. Ft.	150-25-247	A-1	1-2
T104	Bomb Storage	896 Sq. Ft.	150-25-247	A-1	1-2
T105	Fuse Storage	50 Sq. Ft.	150-25-247	A-1	1-2
T106	Fuse Storage	50 Sq. Ft.	150-25-247	A-1	1-2
T107	Bomb Storage	896 Sq. Ft.	150-25-247	A-1	1-2
T108	Bomb Storage	896 Sq. Ft.	150-25-247	A-1	1-2
T109	Bomb Storage	896 Sq. Ft.	150-25-247	A-1	1-2
T110	Bomb Storage	896 Sq. Ft.	150-25-247	A-1	1-2
T111	Fuse Storage	50 Sq. Ft.	150-25-247	A-1	1-2
T112	Fuse Storage	50 Sq. Ft.	150-25-247	A-1	1-2
T113	S.A. Storage & Office	1800 Sq. Ft.	T05-25-9	A-1	1-2
T114	Guard Shelter	1-Man	150-25-251	A-1	1-2
T115	Latrine	Pit, L, 2 Holes	T0-11-30	A-1	1-2
T116	Bomb Storage	896 Sq. Ft.	150-25-247	A-1	1-2
T117	Bomb Storage	896 Sq. Ft.	150-25-247	A-1	1-2
T118	Bomb Storage	896 Sq. Ft.	150-25-247	A-1	1-2
T119	Bomb Storage	896 Sq. Ft.	150-25-247	A-1	1-2
T120	Fuse Storage	50 Sq. Ft.	150-25-247	A-1	1-2
T121	Guard Shelter	1-Man	150-25-251	A-1	1-2
T130	Trop House No. 1	36 sq. ft.	1600-170	PD-A-876	2
T131	Blinder Adj. to Trop. Hse. No. 1		1600-170	PD-A-876	2
T132	Blinder Adj. to Trop. Hse. No. 7		1600-170	PD-A-876	2
T133	Trop House No. 7	36 sq. ft.	1600-170	PD-A-876	2
T134	Pull Box		1600-170	PD-A-876	2
T135	Foot Bridge	2'x4'	1600-170	PD-A-876	2
T136	Foot Bridge	12'x5'	1600-170	PD-A-876	2
T150	Crew Shelter	2-Crews	T03-25-9	A-1	2
T151	Crew Shelter	2-Crews	T03-25-9	A-1	2
T152	A.C. Fueling System	Pump & Engine 2,500 gal. tanks	T25-13-11	A-1	2
T153	Crew Shelter	2-Crews	T03-25-9	A-1	2
T154	Crew Shelter	2-Crews	T03-25-9	A-1	2
T155	A.C. Fueling System	Pump & Engine 2,500 gal. tanks	T25-13-11	A-1	2
T156	Crew Shelter	2-Crews	T03-25-9	A-1	2
T157	Crew Shelter	2-Crews	T03-25-9	A-1	2
T158	Crew Shelter	2-Crews	T03-25-9	A-1	2
T160	Crew Shelter	2-Crews	T03-25-9	A-1	2
T161	Crew Shelter	2-Crews	T03-25-9	A-1	2

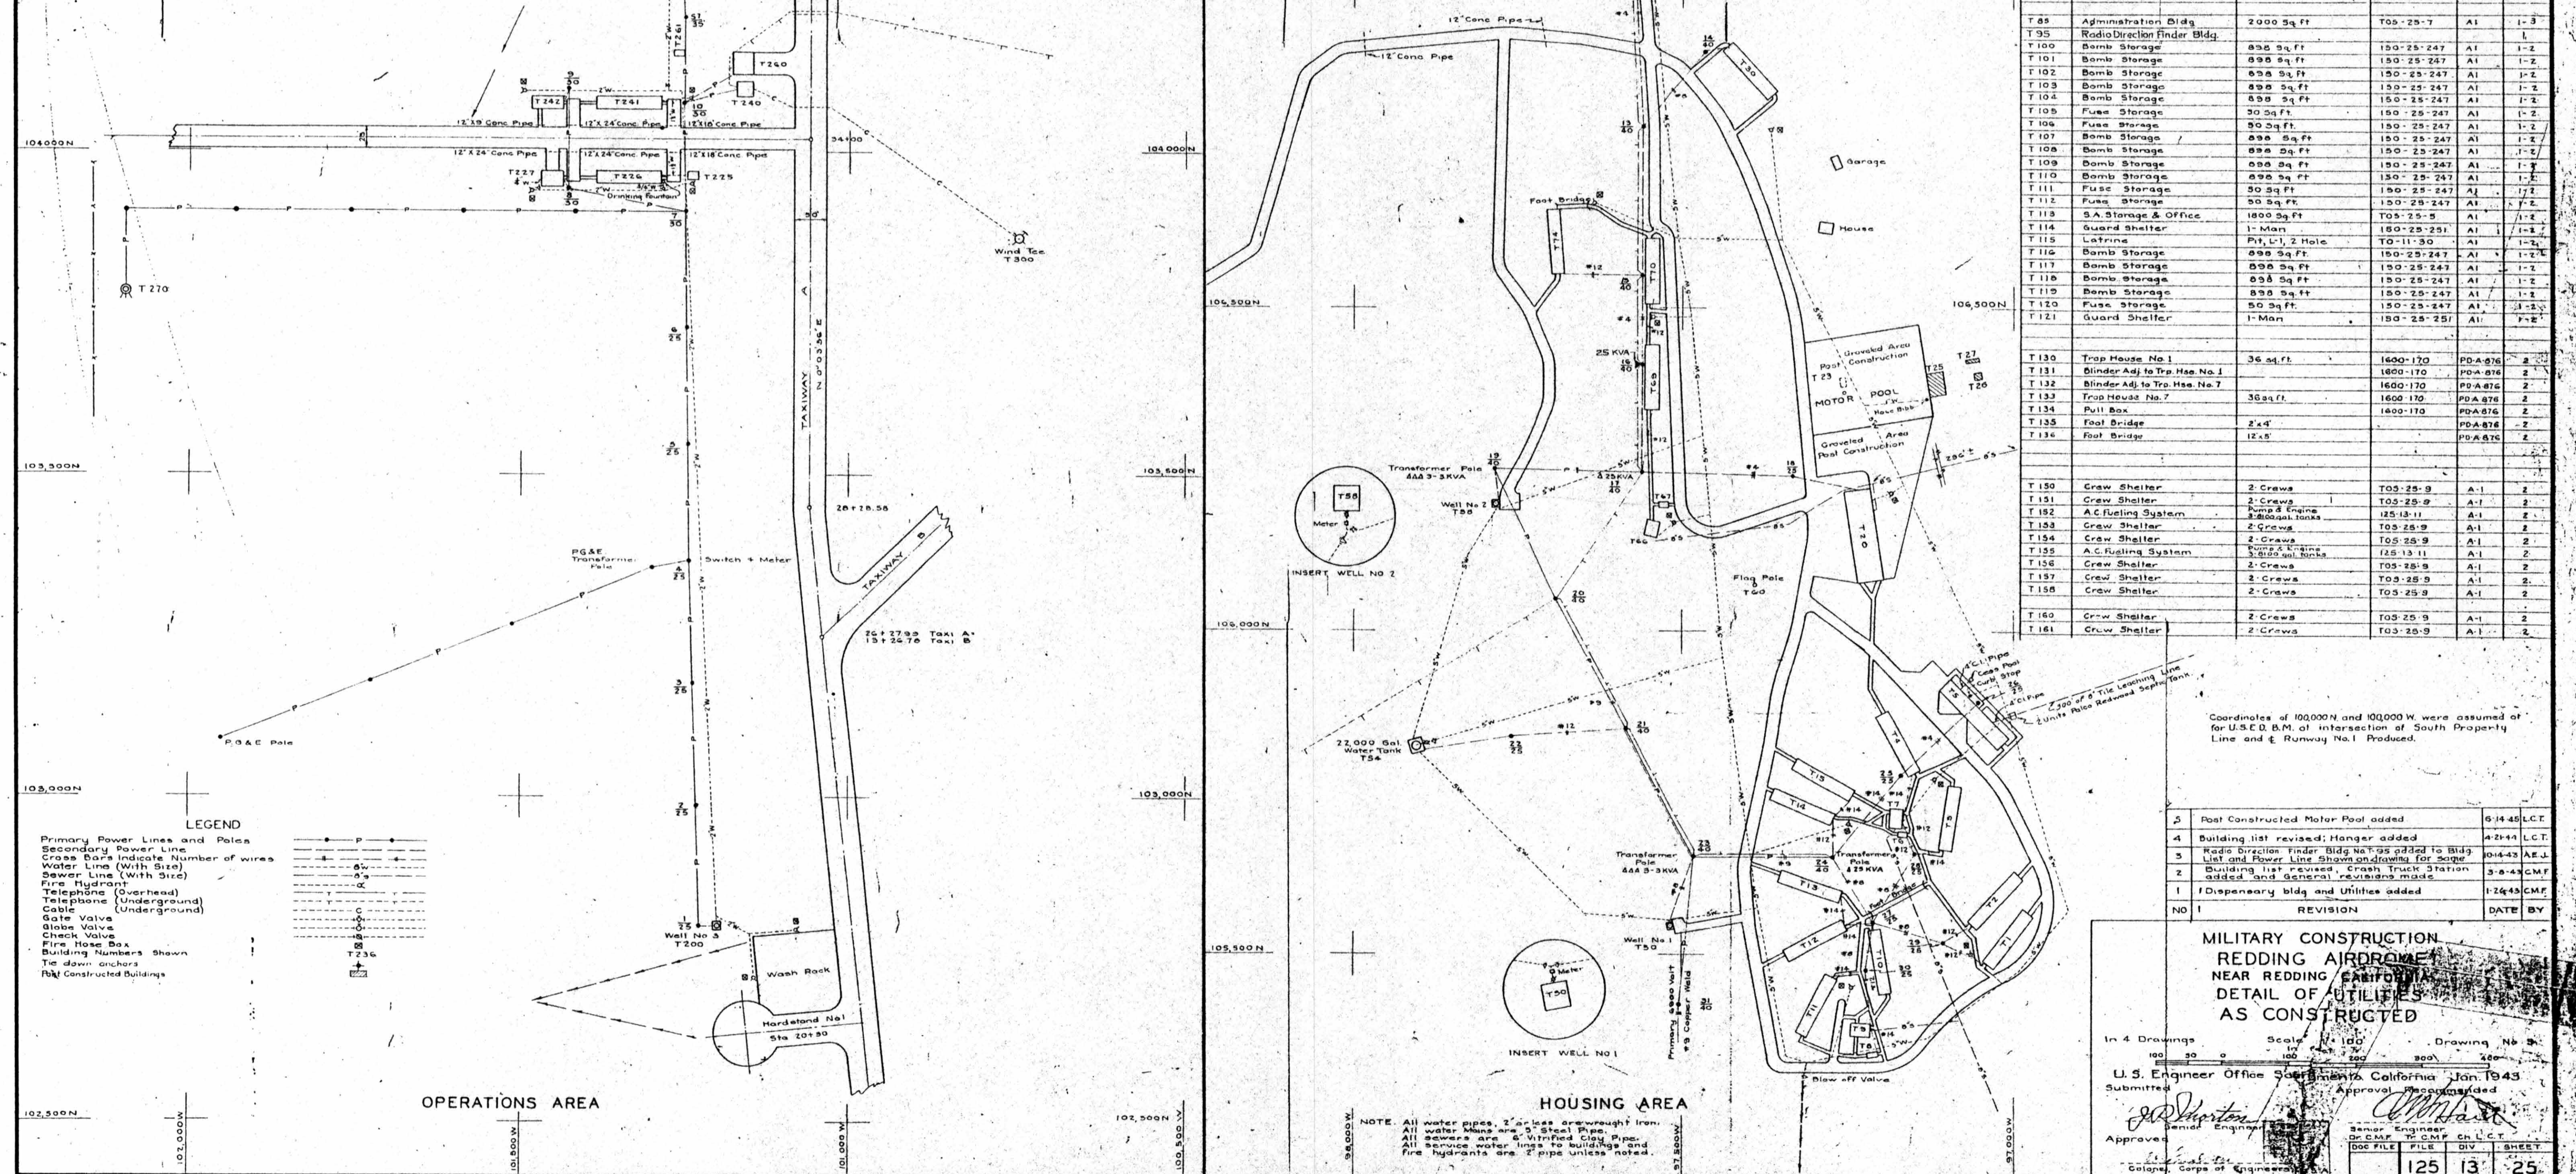

Coordinates of 100,000N and 100,000W were assumed for U.S.C.D. B.M. at intersection of South Property Line and E. Runway No. 1. Produced.

NO.	REVISION	DATE	BY
5	Post Constructed Motor Pool added	6-14-45	L.C.T.
4	Building list revised; Hanger added	4-24-44	L.C.T.
3	Radio Direction Finder Bldg No. 95 added to Bldg List and Power Lines shown on drawing for same	10-14-43	A.E.J.
2	Building list revised; Crash Truck Station added and general revision made	3-8-43	C.M.F.
1	Dispensary bldg and Utilities added	1-24-43	C.M.F.

MILITARY CONSTRUCTION
REDDING AIRFIELD
 NEAR REDDING, CALIFORNIA
DETAIL OF UTILITIES
AS CONSTRUCTED

In 4 Drawings Scale 1" = 100' Drawing No. 3
 U.S. Engineer Office Sacramento, California Jan 1943
 Submitted: Approved: [Signature]
 Approved: [Signature] Senior Engineer
 DoC FILE FILE L.C.T.
 125 13 25

NOTE: All water pipes, 2" or less are wrought iron. All water mains are 3" steel pipe. All sewers are 6" vitrified clay pipe. All service water lines to buildings and fire hydrants are 2" pipe unless noted.