
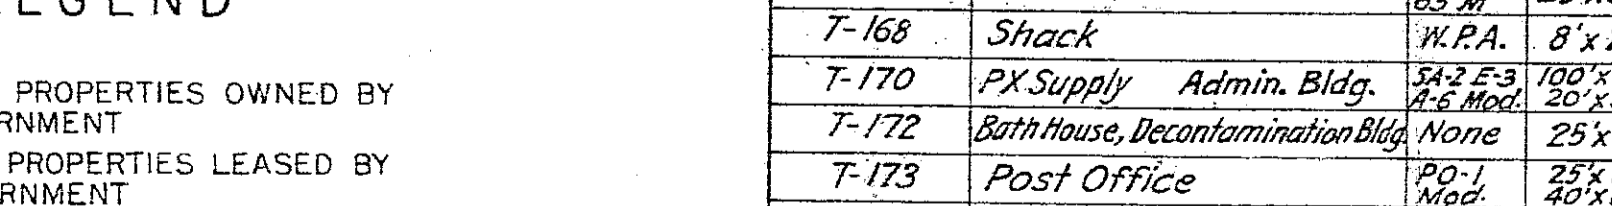
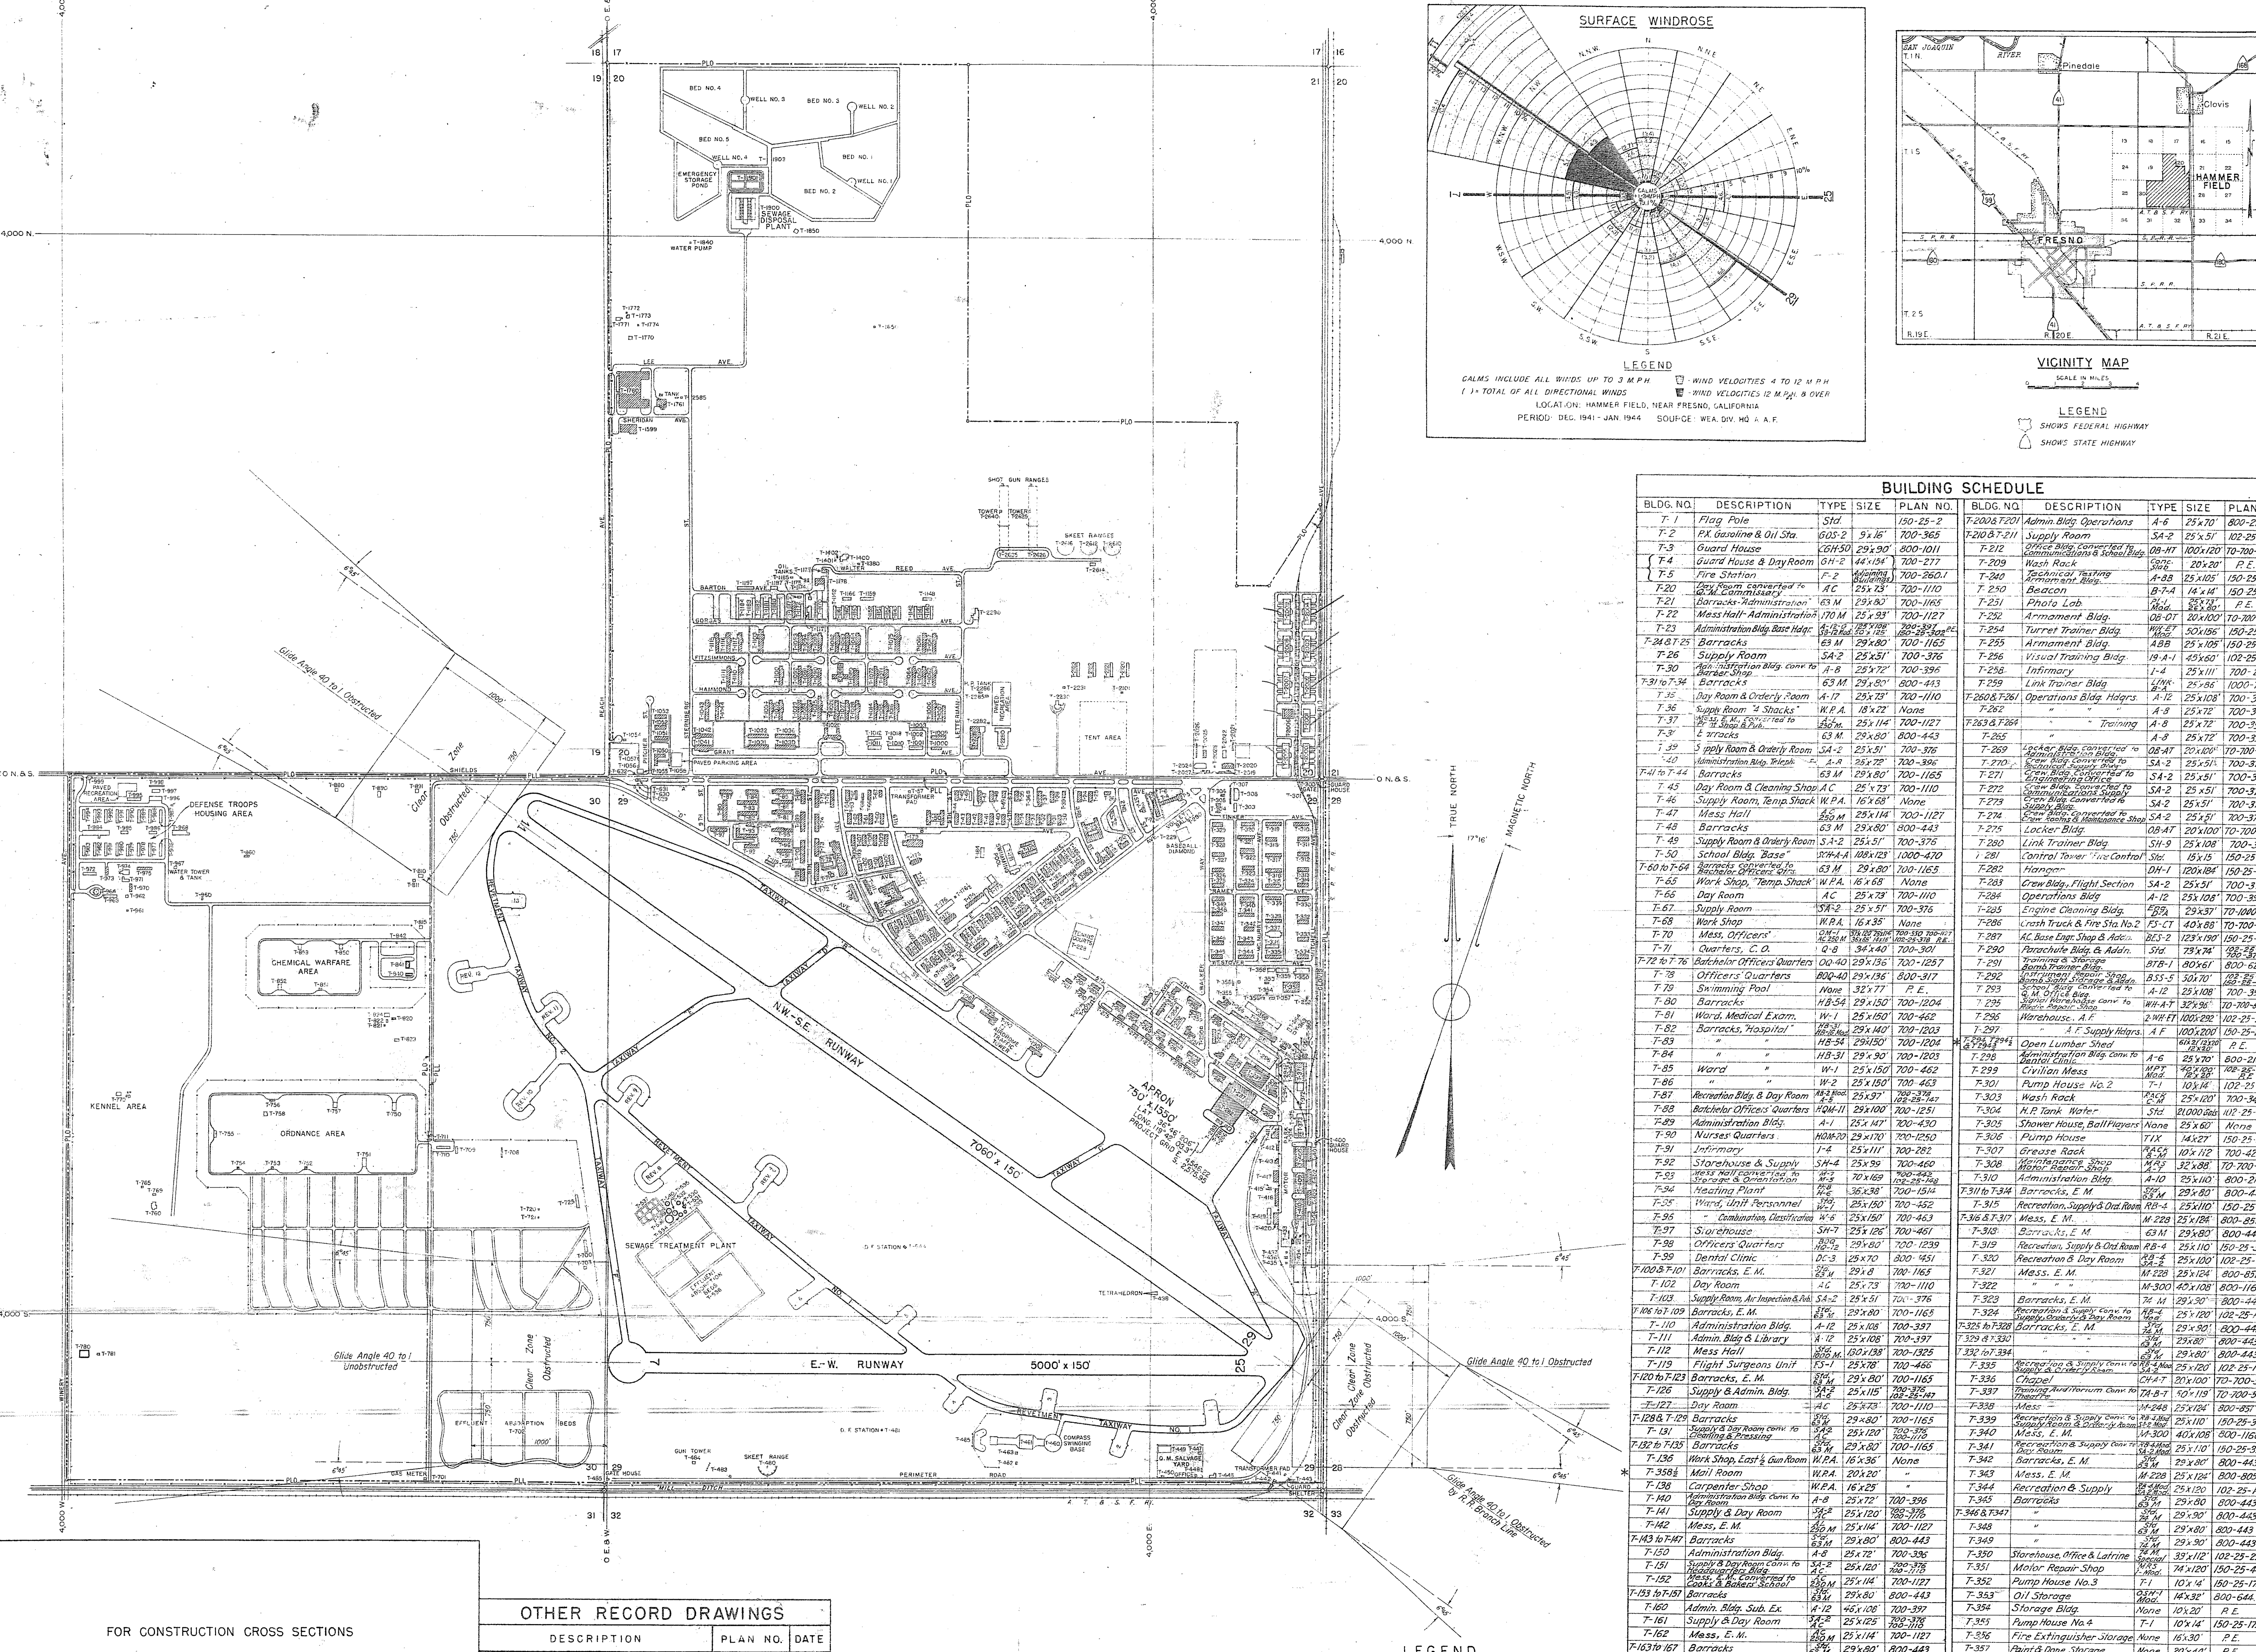


BUILDING SCHEDULE

Table with columns: BLDG. NO., DESCRIPTION, TYPE, SIZE, PLAN NO., BLDG. NO., DESCRIPTION, TYPE, SIZE, PLAN NO. Lists various buildings such as Barracks, Mess Halls, and Workshops with their respective specifications.

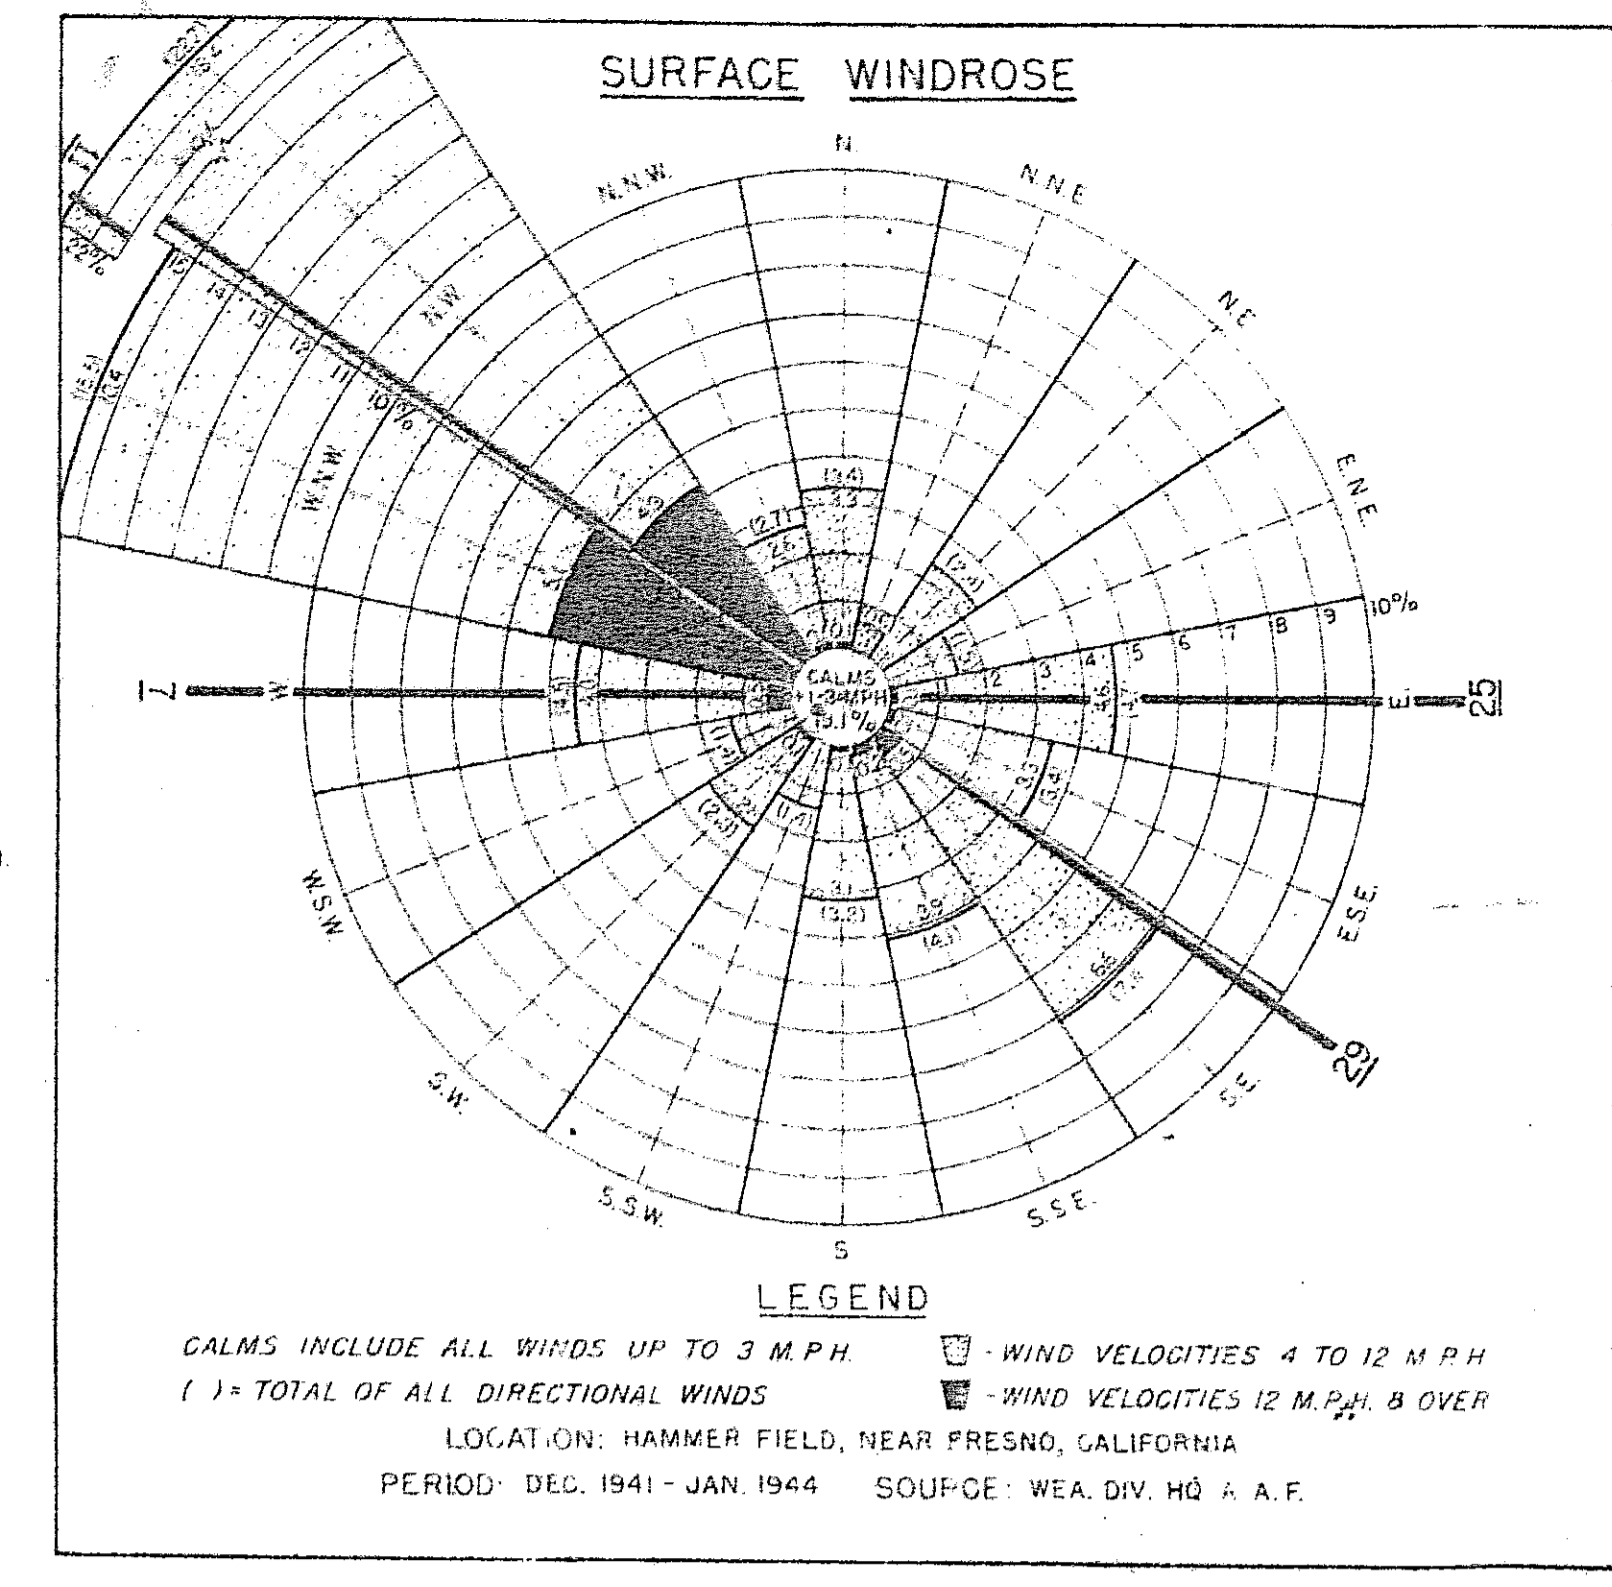

FOR CONSTRUCTION CROSS SECTIONS SEE PAVEMENT EVALUATION REPORT OF JAN., 1943

OTHER RECORD DRAWINGS table with columns: DESCRIPTION, PLAN NO., DATE. Lists drawings like Unit Layout Maps and Sept. 1943.

Project title block containing: LEGEND, GRAPHIC SCALE, MILITARY CONSTRUCTION HAMMER FIELD ARMY AIR BASE NEAR FRESNO, CALIFORNIA, BASIC LAYOUT PLAN, U.S. ENGINEER OFFICE, SACRAMENTO, CALIFORNIA, SHEET NO. 1, and drawing details.